

Redmarking

originated 12/15/09
by RAH
last edited: 07-/21/10
by RAH



Technique

- | No | Task |
|----|---|
| | Work uninterrupted as your brain remembers the issues involved in that type of work or project, it will bring up related associations, like priming a pump, really. You'll do lots better than if you get interrupted with phone calls and people every 10 or 15 mins. I'd say minimum of 2 hr bursts for maximum efficiency and completeness |
| 1 | |
| 2 | Redmark |
| 3 | Review Checklists for PM / Staff on job, relook at dwgs. This is probably the most important part. |
| 4 | Review client or external reviewers comments. |
| 5 | Review any meeting minutes that might have had work items that need to be incorporated into the documents. |
| 6 | Highlight or circle any items that have to be discussed with clients or consultants |
| 7 | General redmarks on first sheets or at title block to sheet if possible, ie comments that involve several items on that sheet, or throughout all the sheets. |
| 8 | Scan |
| 9 | Bubble in blue the items that you feel must make it into the next submission (especially if it's known that insufficient time / staff exist to get all the comments addressed) |

Skills Required



Click on images below to open PDF files with instructions

1 Scanning with wide format scanner

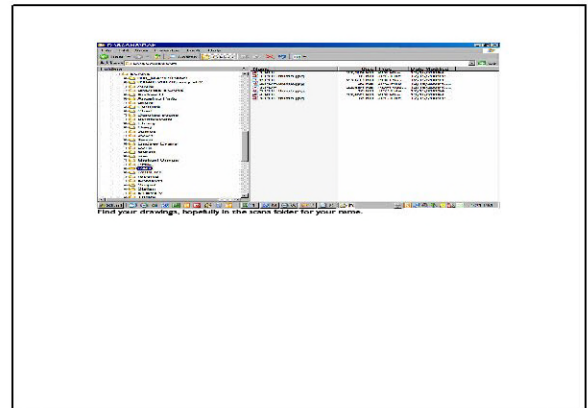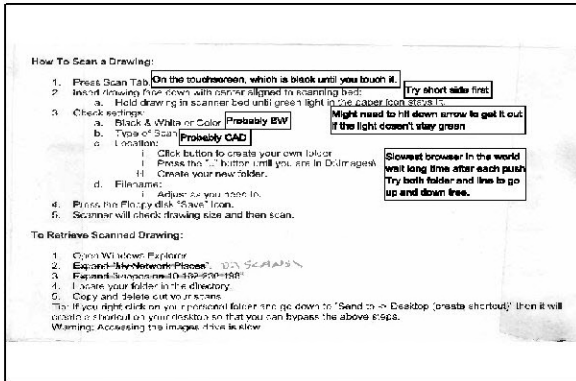

2 Troubleshooting scans / pdf reading

3 Using PDF Converter Pro to Redmark Drawing

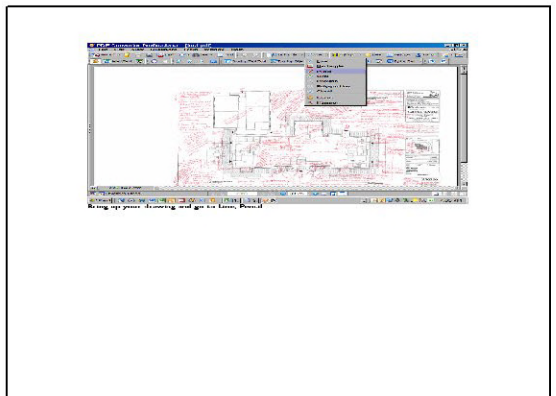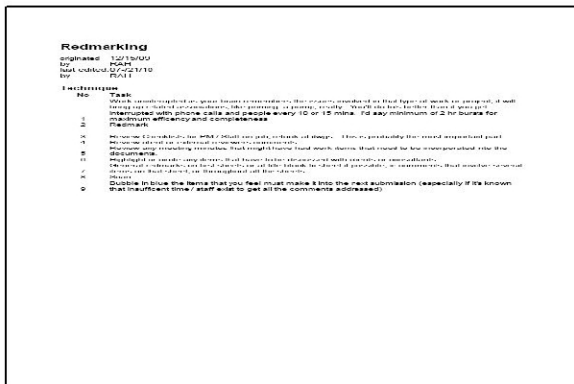

4 Changing pen to wide light blue

Stuff in blue shows scope should

3. All dimensions approximate. Go to verify in field all dimensions before starting work.
General Notes


Protect building fencing & set property from damage by vehicles & equipment used to perform the work. Replace anything damaged at end of work. Replace concrete in full flag & paving in full sections.

2. Ensure all new paving slopes to drain away from the existing building.

Similar what is in my slope is already in place. Do we want settling in water eventually ponding around building?

No motorized construction equipment to play areas.

Show some of the work. If it's replace protective curbs. Replace any pads down on asphalt. Coordinate work in this area w/ school to not interfere with use of this area.

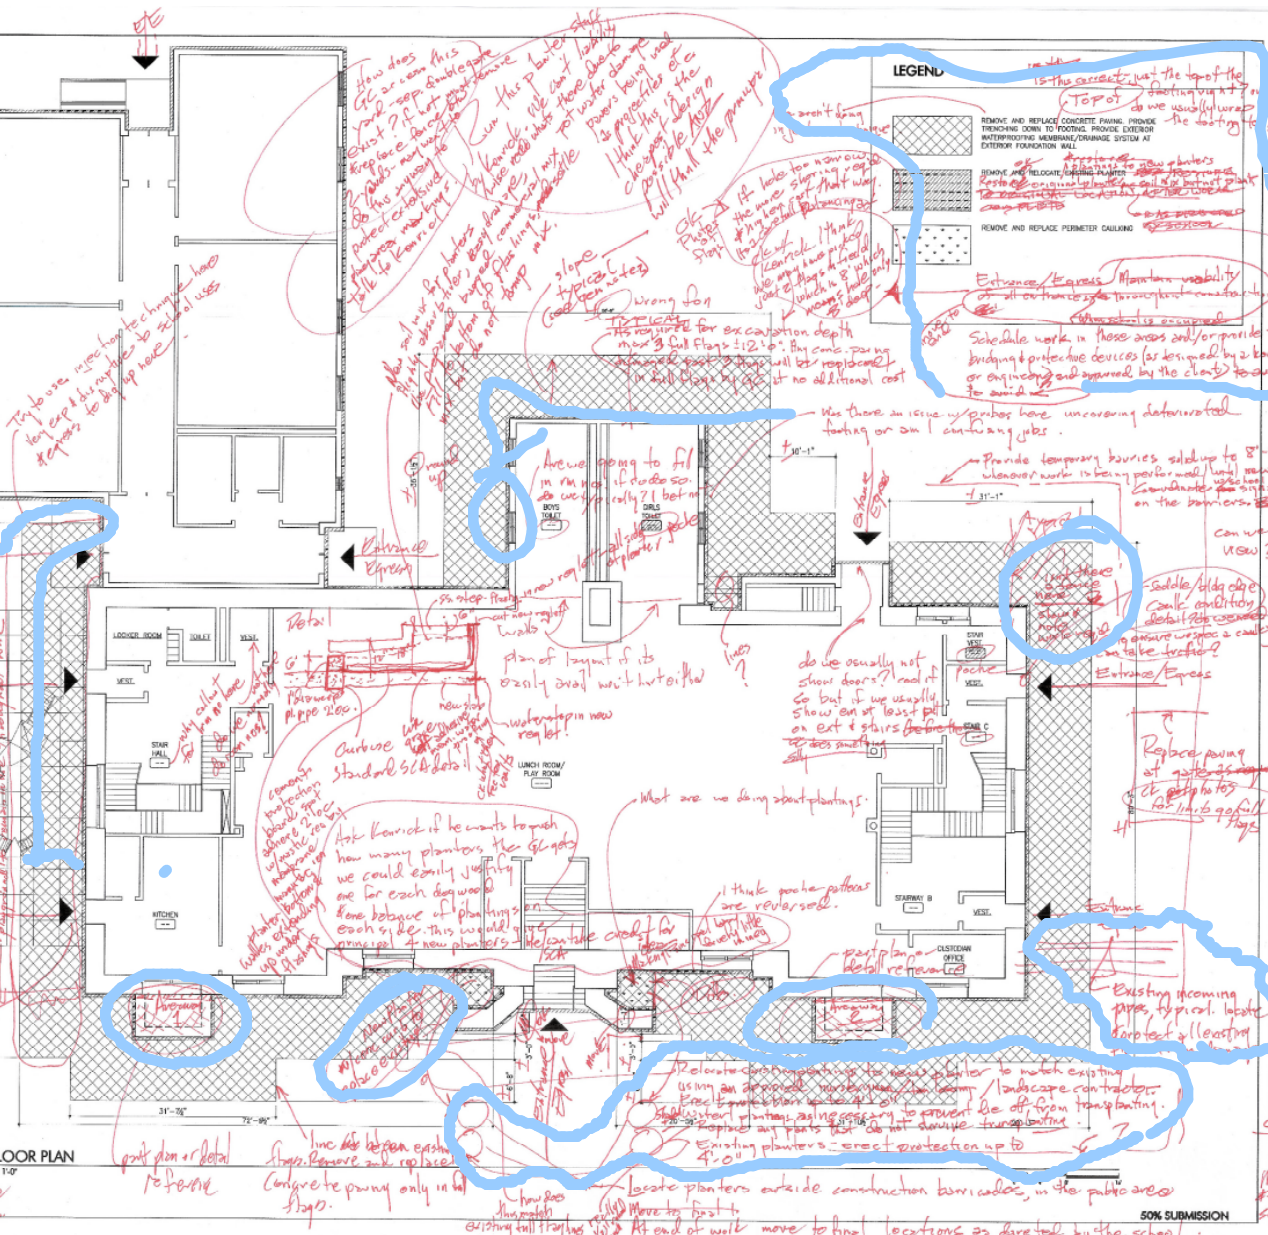

LEGEND

- REMOVE AND REPLACE CONCRETE PAVING. PROVIDE TRENCHING DOWN TO FOOTING. PROVIDE EXTERIOR INTERLOCKING MEMBRANE DRAINAGE SYSTEM AT EXTERIOR FOUNDATION WALL.
- REMOVE AND REPLACE PERIMETER CALLING.

Deleted at request of firm

GoshowArchitects
1001 5th Avenue, 5th Fl New York, NY 10001
212.375.1732/312.375.1740

Deleted at request of firm

Deleted at request of firm

Date	Revision

Deleted at request of firm

Deleted at request of firm

Drawing Title: **FIRST FLOOR PLAN**

Drawn by: **A102.00**

Checked by: **5 of 12**

Sheets in DDB Set: **5 of 12**

Submission